
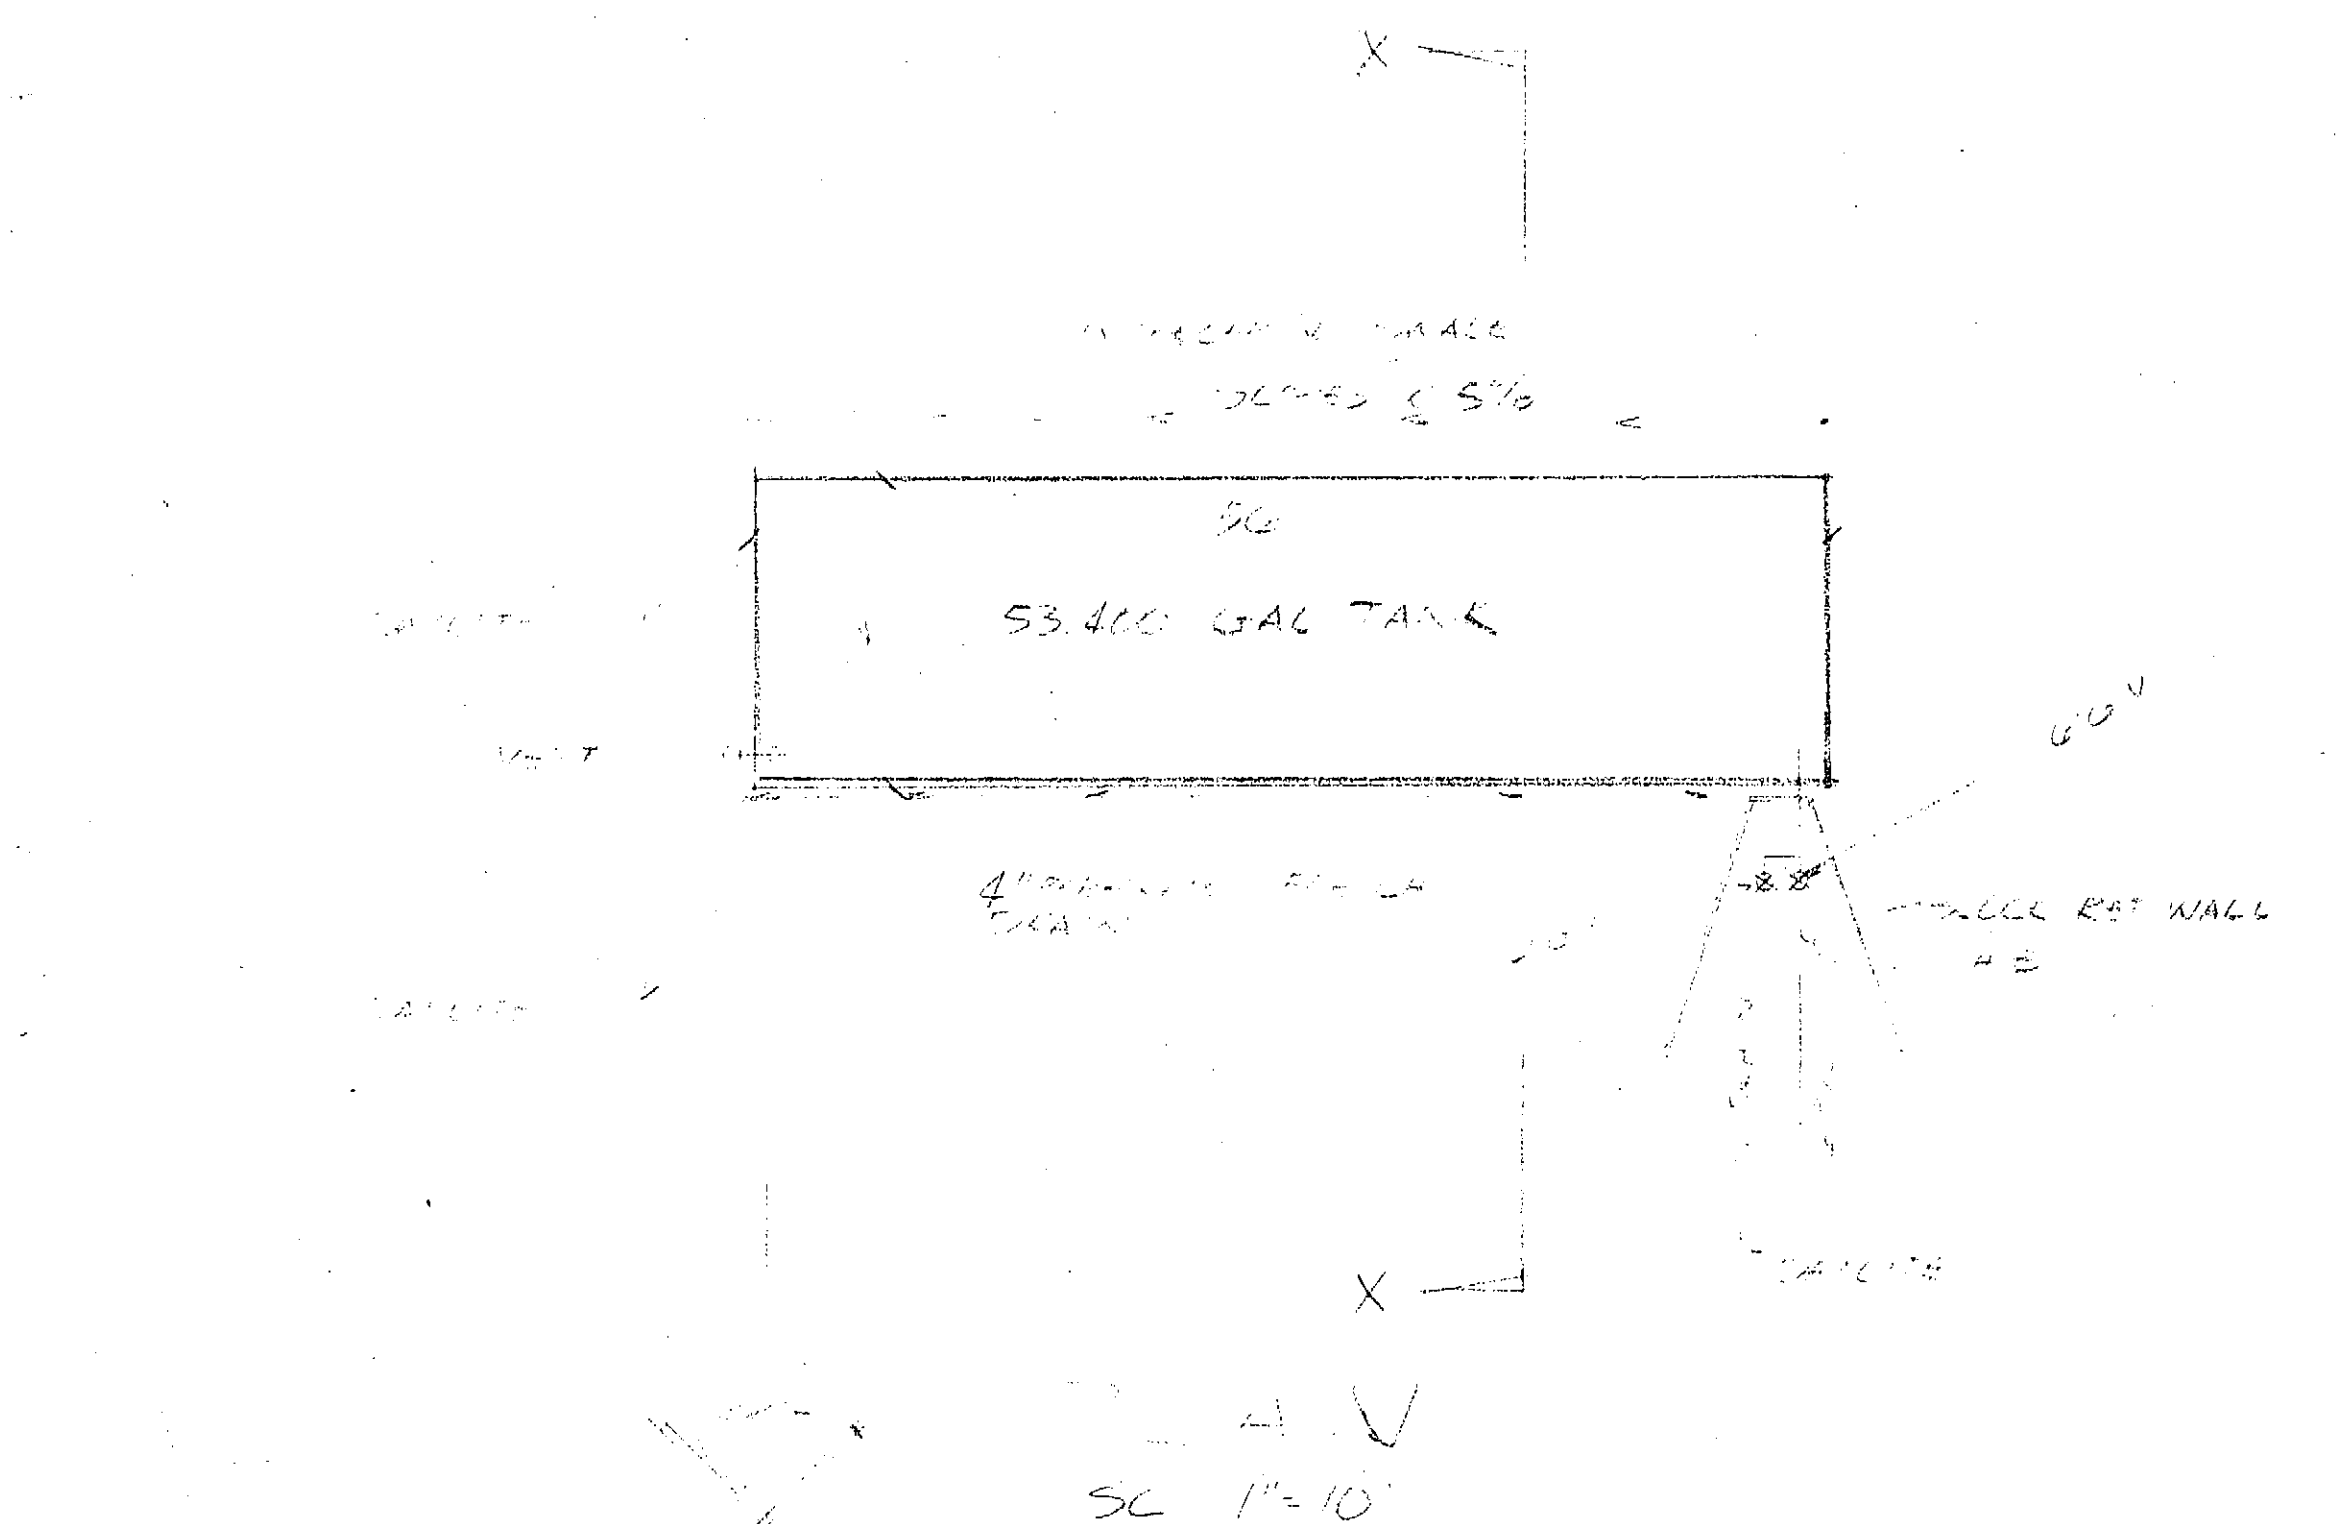


NOTE
THE TANK WAS WATERPROOFED
USING G.S. 300 ELASTOMERIC URETHANE
COATING APPLIED PER INSTALLATION
SPECIFICATIONS OF THE MANUFACTURER,
GROVE INTERNATIONAL, INC.

I HAVE INSPECTED THE CONSTRUCTION SHOWN
HEREON AND THIS PLAN CONFORMS TO THE
"AS BUILT" CONDITIONS

GORDON C. HOLMES RCE 10467

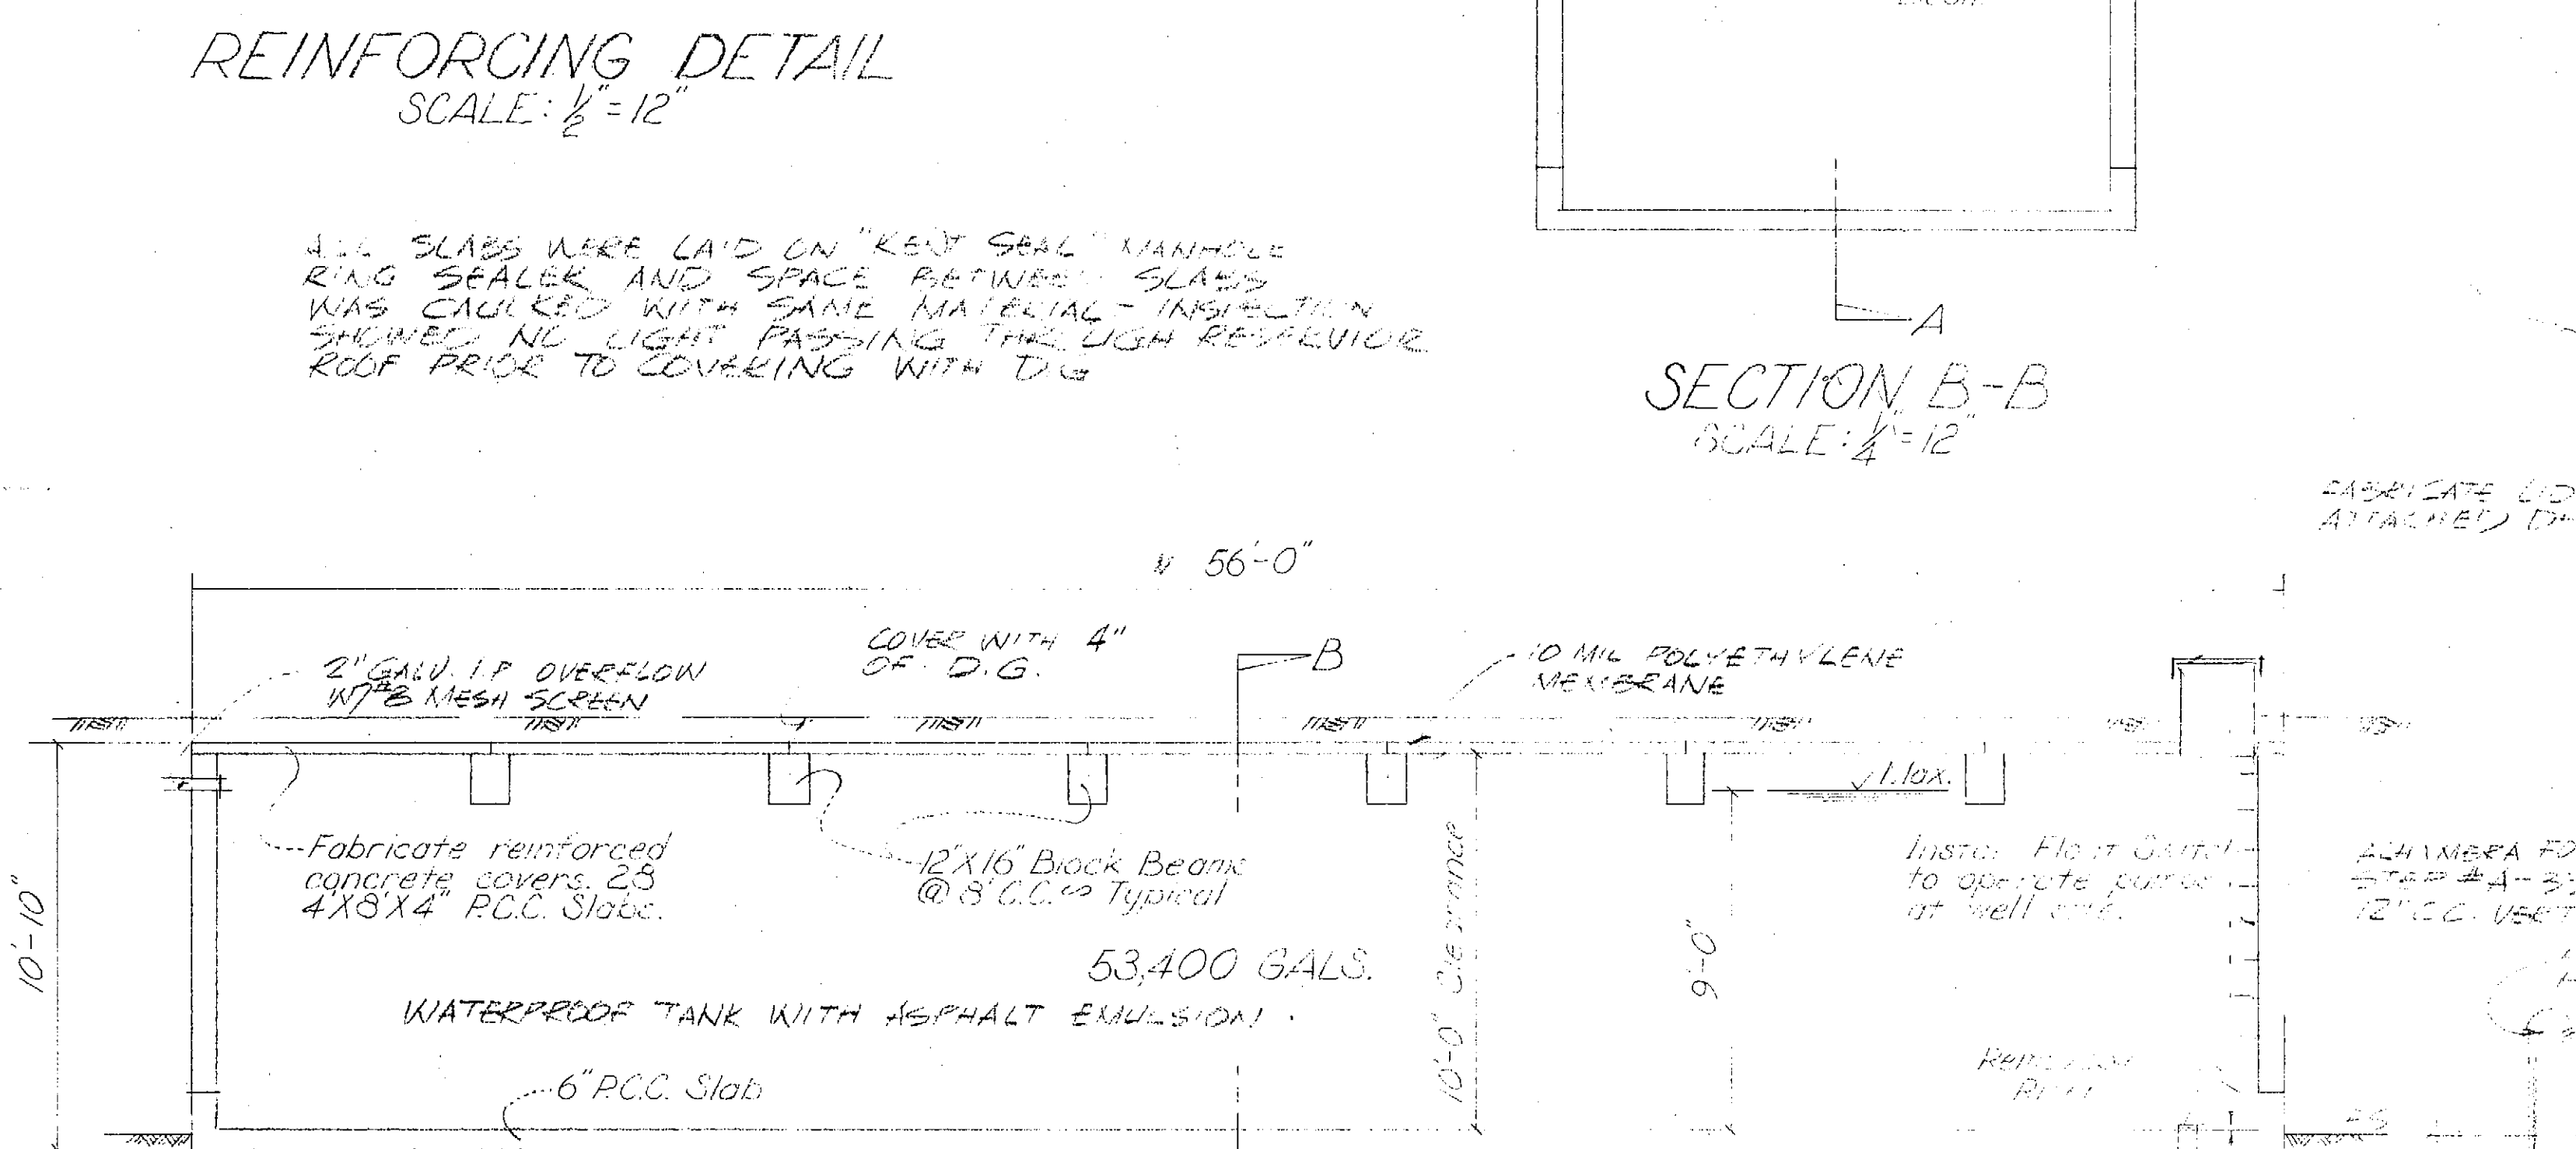

- RESERVOIR NOTES:
1. Grout all block cells solid, mix to be Hiatt Sand & Gravel Co. - 4 parts pea gravel mix - 1 part cement
 2. Concrete to be Hiatt Sand & Gravel Co. 6 sack mix - Max. Aggregate size = 1 dia.

MISC. RESERVOIR DETAILS
WATER DISTRIBUTION
SYSTEM
FOR

GORDON C. HOLMES - RCE 10467
106 South Main Street
Bishop, California
Phone: 714-873-4273

ALPINE WATER CO.
9-14-79

REV. 10-3-79
REV. 10-10-79 (REINFORCING DETAIL)